


REVISIONS				
REV	DATE	DRW'N	CHCK'D	DESCRIPTION
A	19SEP17	GFC	--	INITIAL RELEASE
B	21SEP17	GFC	--	MATERIAL CHANGE
C	25Sep17	GFC	--	NOTE 3
D	26OCT17	GFC	DM	SURFACE TEXTURE
E	19JUN18	GFC	SP(KECK)	AS-BUILT

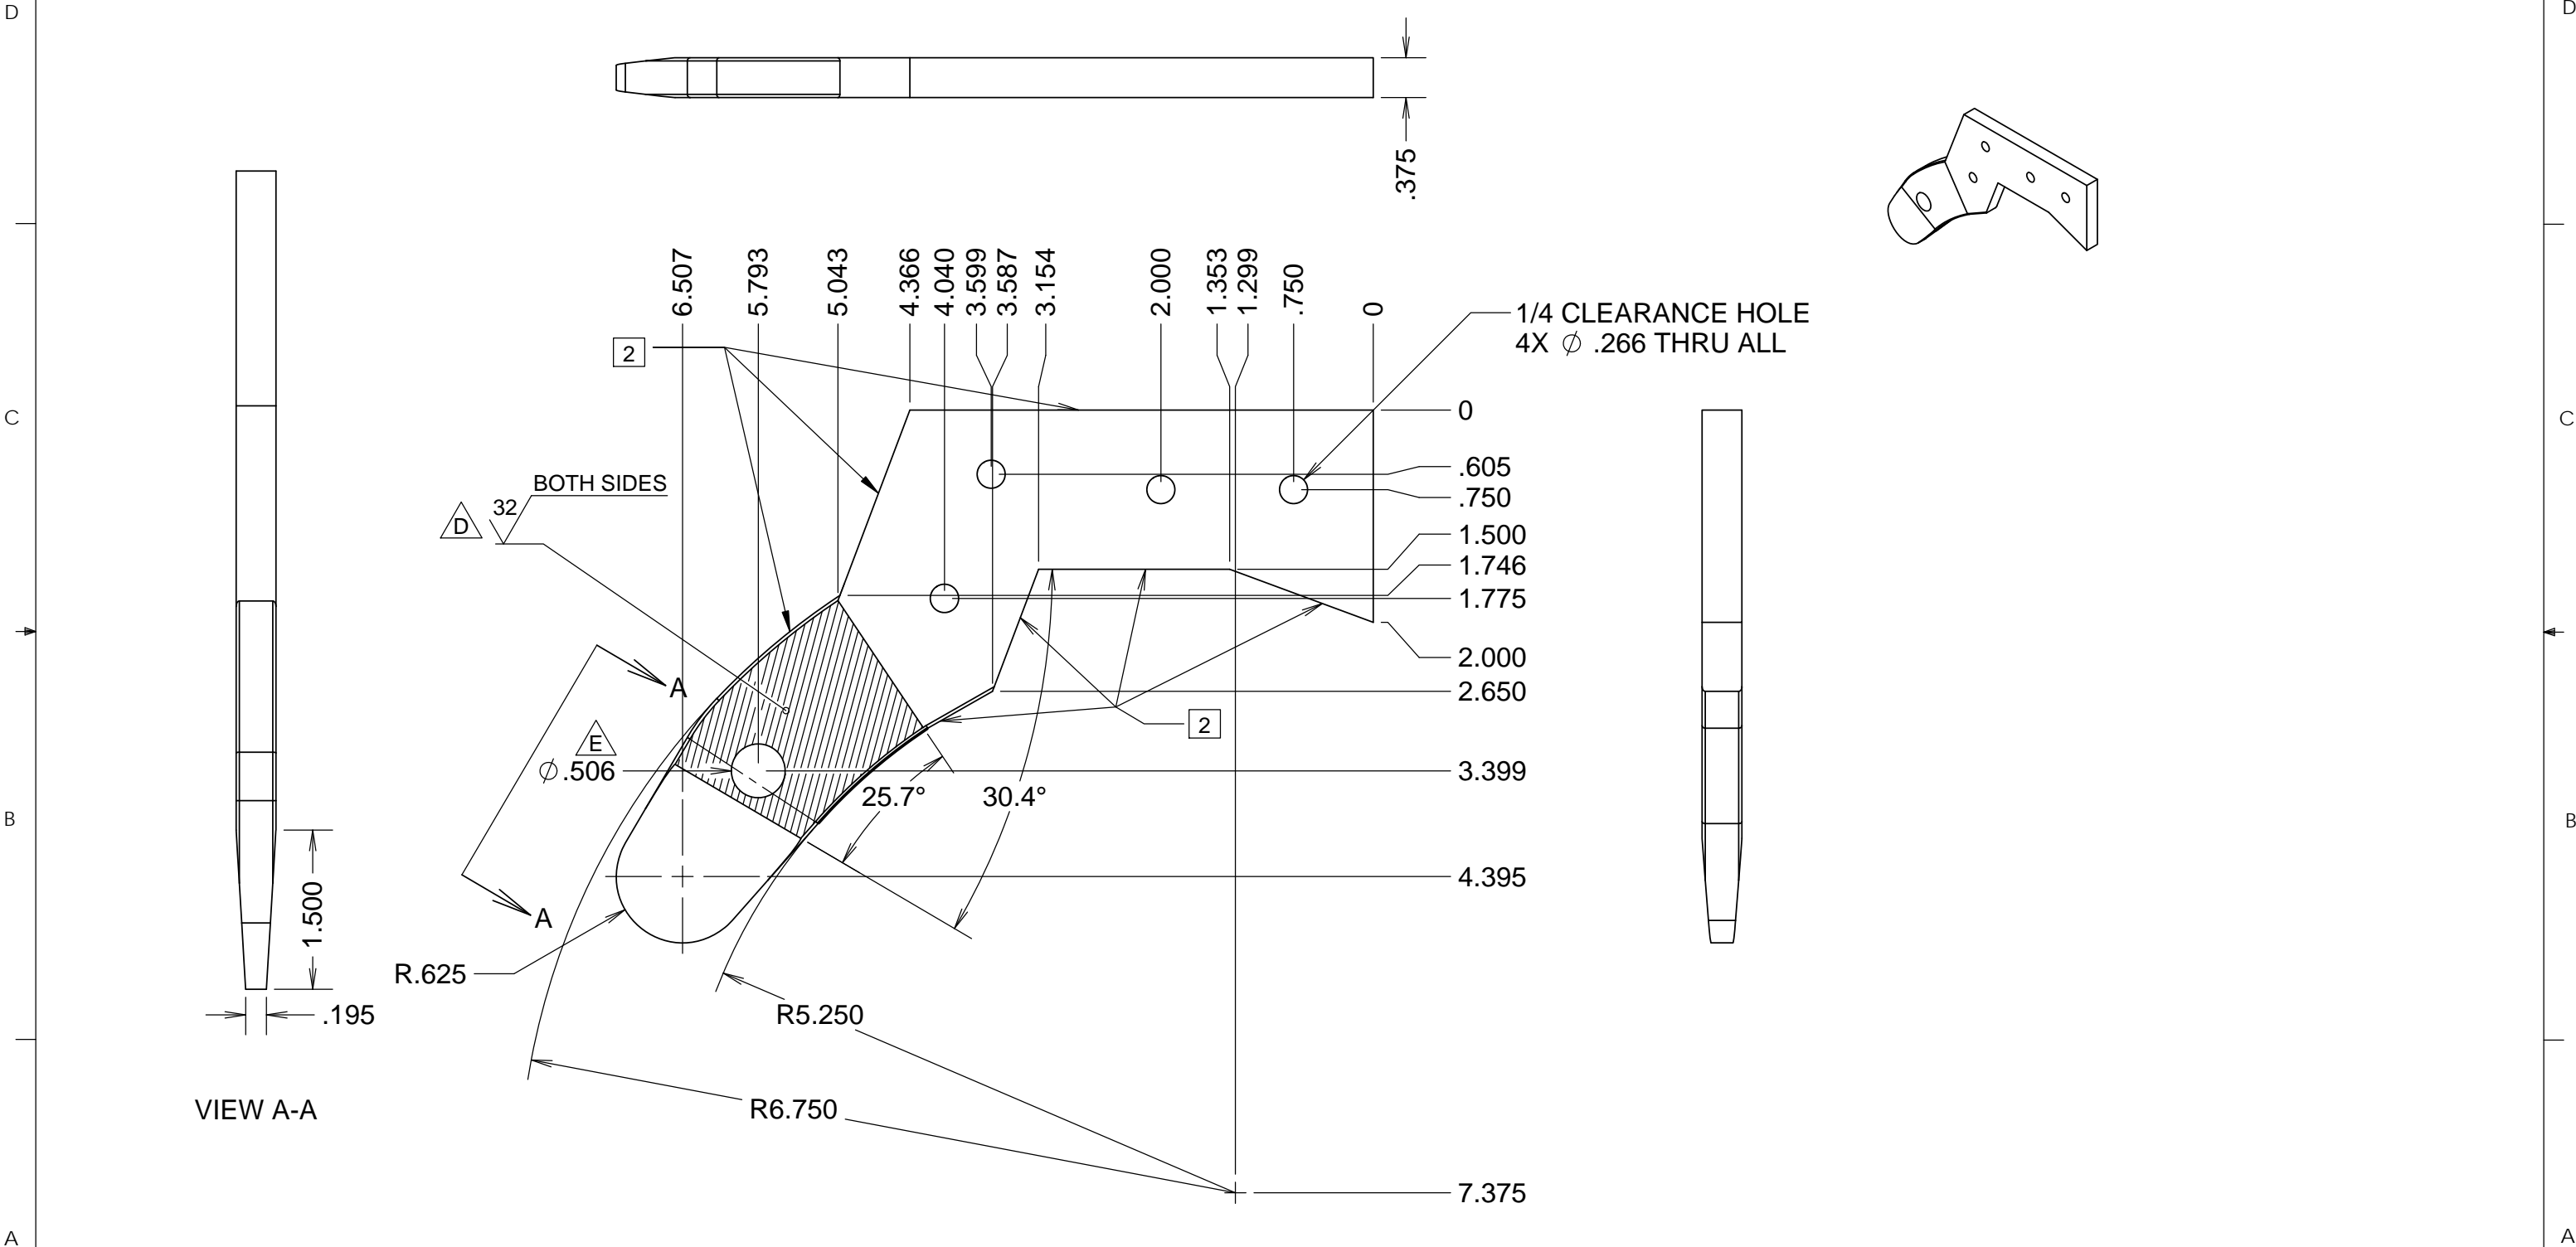

NOTES

- 1 CAD MODEL FILENAME, 872-LM1312 Tang
- 2 PAINT EDGE ONLY ON SURFACES NOTED, AEROGLAZE X3-6 FLAT BLACK PER MFGR'S SPEC

UNLESS OTHERWISE NOTED DIMENSIONS ARE IN INCHES & TOLERANCES ARE AS FOLLOWS

X.X: ±0.1000"	X.XX: ±0.0100"
X.XXX: ±0.0050"	X.XXXX: ±0.0001"
ANGLES: ±0.5° FINISH: 125 MICRO INCHES BREAK ALL SHARP EDGES & CORNERS .002" MAX	
MATERIAL SST 304	FINISH 64



DRAWN CABAK	--	KECK 1 DEPLOYABLE TERTIARY MIRROR
CHECKED --	--	STOW & DEPLOY SYSTEM
DESIGNED CABAK	--	TITLE TANG
DRAWN CABAK	--	
SW DOCUMENT FILE 1	PROJECT CODE K1D3FD	DWG NO 872-LM1312
		E 1/1