


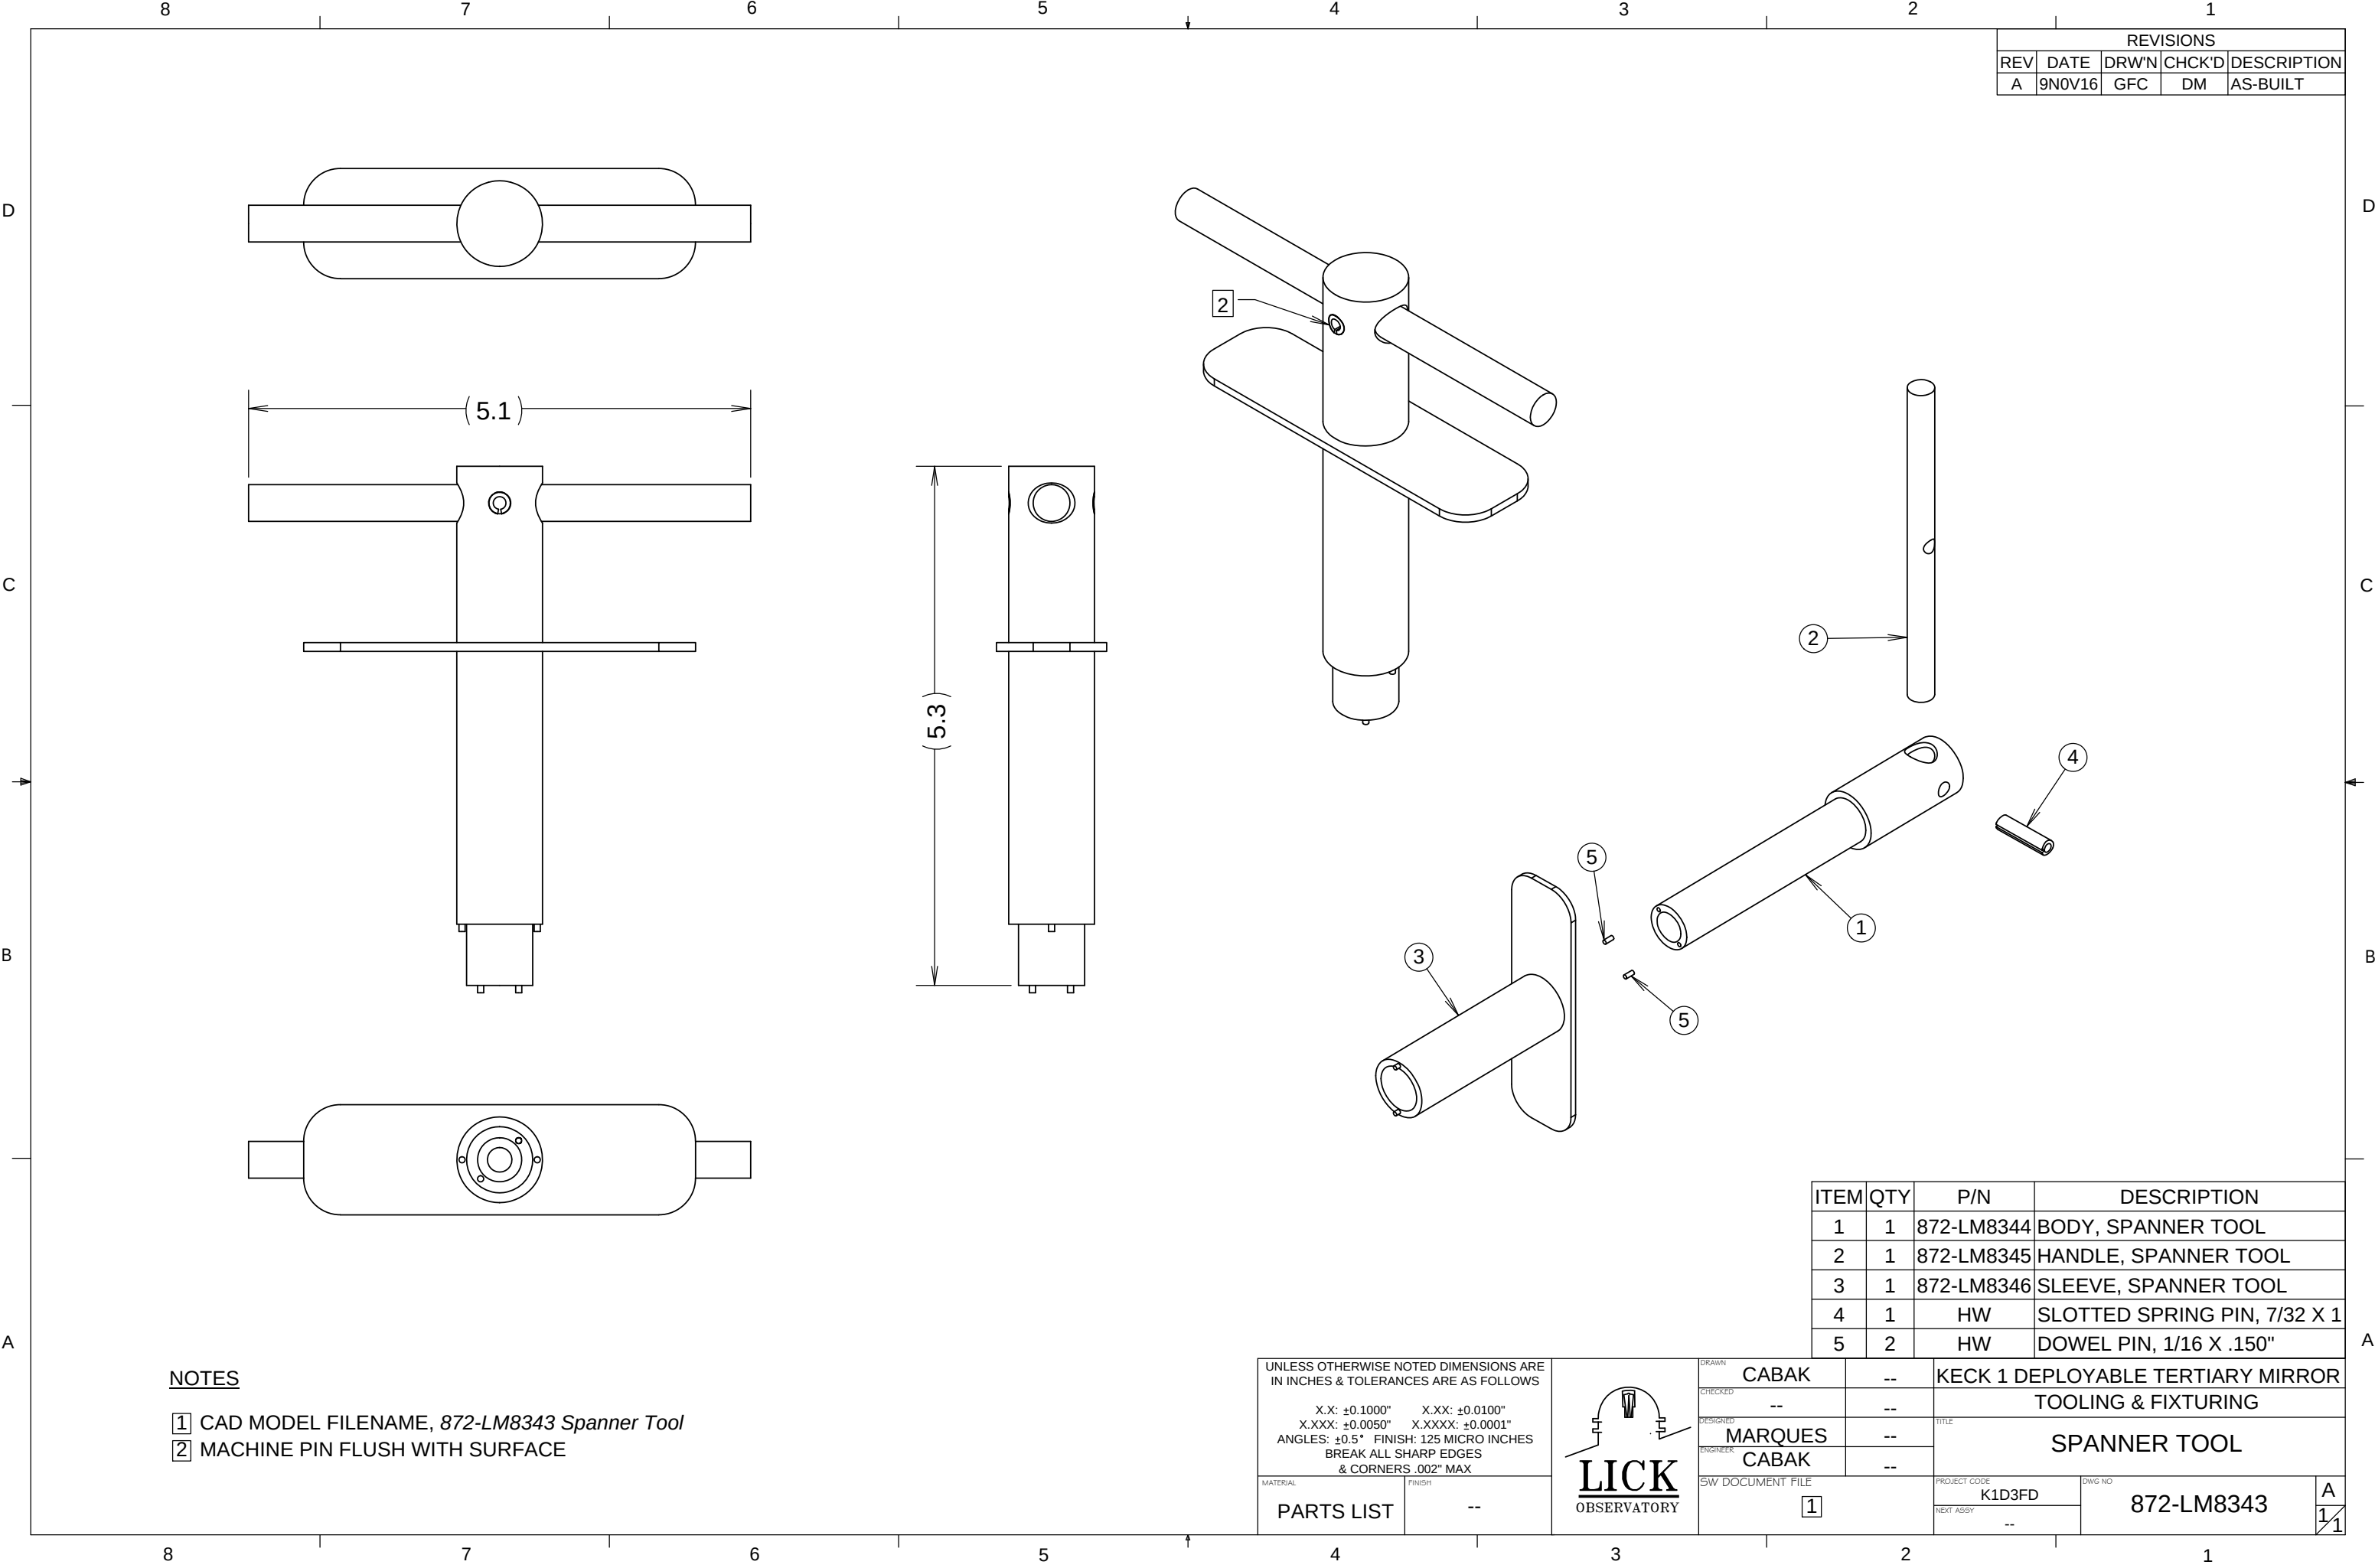

REVISIONS				
REV	DATE	DRW'N	CHCK'D	DESCRIPTION
A	9N0V16	GFC	DM	AS-BUILT

ITEM	QTY	P/N	DESCRIPTION
1	1	872-LM8344	BODY, SPANNER TOOL
2	1	872-LM8345	HANDLE, SPANNER TOOL
3	1	872-LM8346	SLEEVE, SPANNER TOOL
4	1	HW	SLOTTED SPRING PIN, 7/32 X 1
5	2	HW	DOWEL PIN, 1/16 X .150"

NOTES

- 1 CAD MODEL FILENAME, 872-LM8343 Spanner Tool
- 2 MACHINE PIN FLUSH WITH SURFACE

UNLESS OTHERWISE NOTED DIMENSIONS ARE IN INCHES & TOLERANCES ARE AS FOLLOWS	
X.X: ±0.1000"	X.XX: ±0.0100"
X.XXX: ±0.0050"	X.XXXX: ±0.0001"
ANGLES: ±0.5° FINISH: 125 MICRO INCHES BREAK ALL SHARP EDGES & CORNERS .002" MAX	
MATERIAL	FINISH
PARTS LIST	--



DRAWN	CABAK	--	KECK 1 DEPLOYABLE TERTIARY MIRROR	
CHECKED	--	--	TOOLING & FIXTURING	
DESIGNED	MARQUES	--	TITLE SPANNER TOOL	
ENGR/CHK	CABAK	--		
SW DOCUMENT FILE		PROJECT CODE		DWG NO
1		K1D3FD		872-LM8343
		NEXT ASSY		A
		--		1/1