


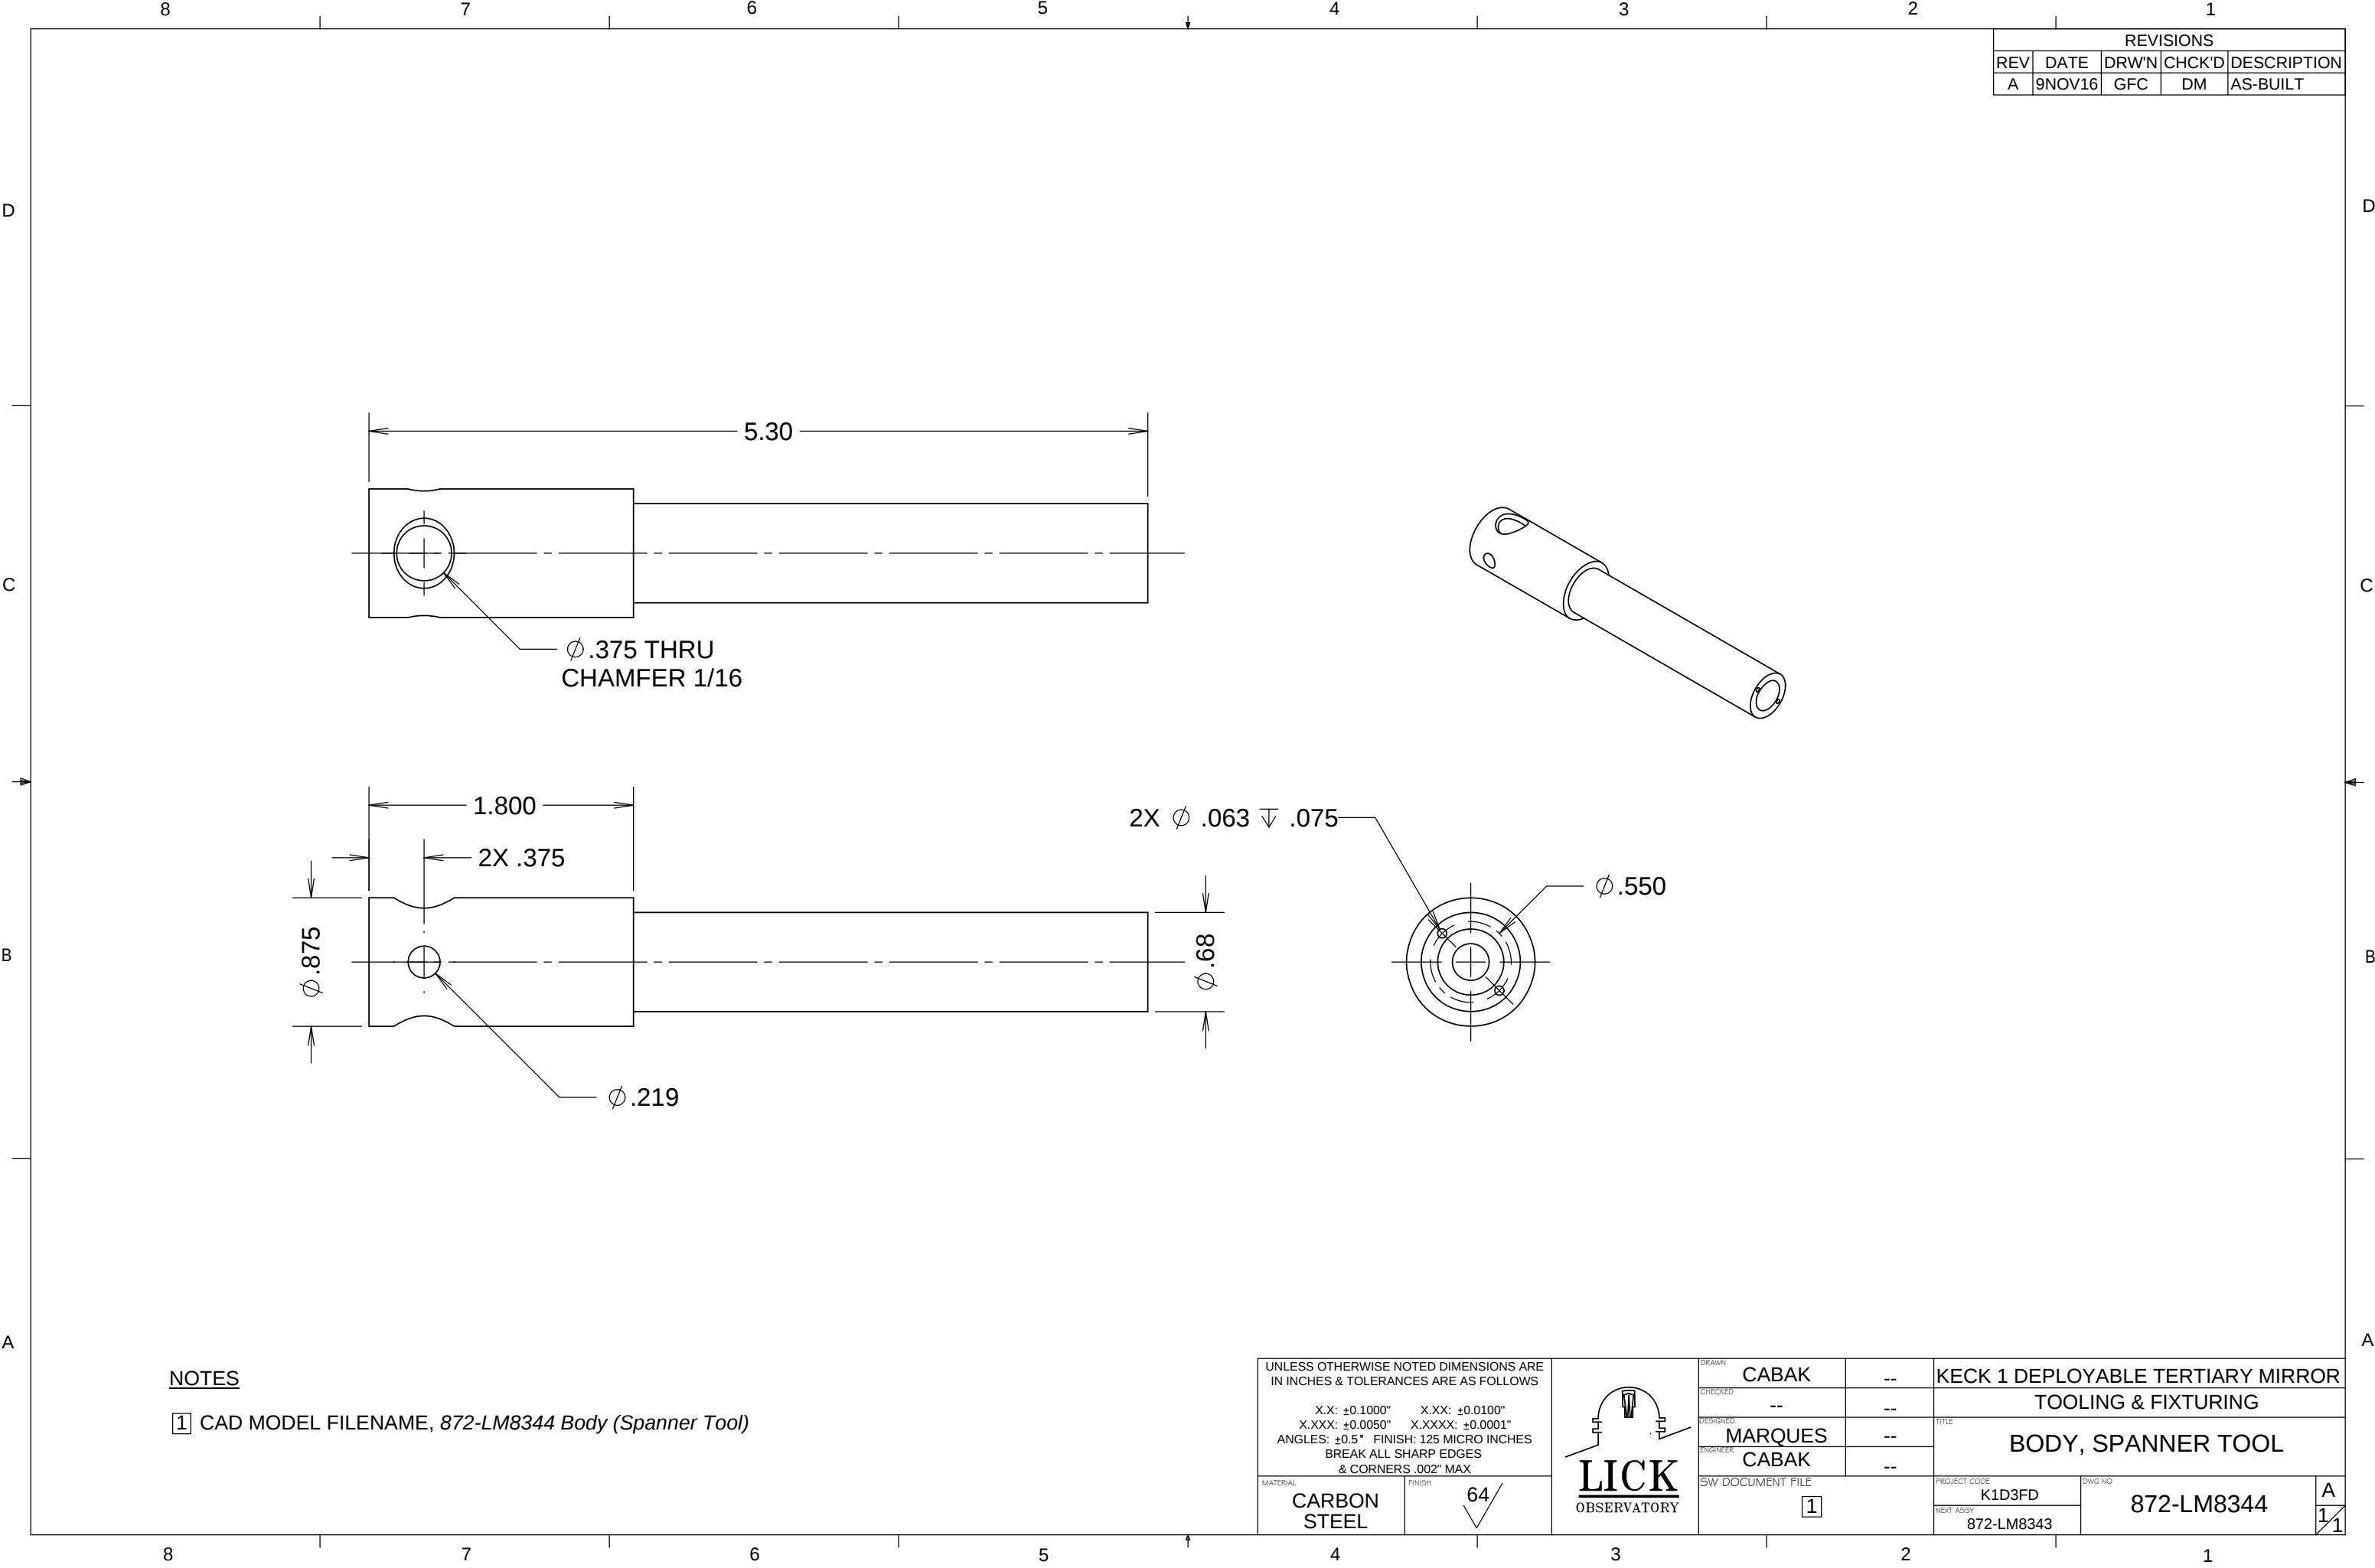

REVISIONS				
REV	DATE	DRW'N	CHCK'D	DESCRIPTION
A	9NOV16	GFC	DM	AS-BUILT

NOTES

1 CAD MODEL FILENAME, 872-LM8344 Body (Spanner Tool)

UNLESS OTHERWISE NOTED DIMENSIONS ARE IN INCHES & TOLERANCES ARE AS FOLLOWS X.X: ±0.1000" X.XX: ±0.0100" X.XXX: ±0.0050" X.XXXX: ±0.0001" ANGLES: ±0.5° FINISH: 125 MICRO INCHES BREAK ALL SHARP EDGES & CORNERS .002" MAX			DRAWN	CABAK	--	KECK 1 DEPLOYABLE TERTIARY MIRROR		
			CHECKED	--	--	TOOLING & FIXTURING		
			DESIGNED	MARQUES	--	TITLE BODY, SPANNER TOOL		
			ENGINEER	CABAK	--			
MATERIAL	FINISH		SW DOCUMENT FILE		PROJECT CODE		DWG NO	A
CARBON STEEL	64 		1		K1D3FD		872-LM8344	1/1
					NEXT ASSY 872-LM8343			

